



No.	DATE	REVISION
V1	MAR 2023	ORIGINAL VERSION

CONSTRUCTION RECORD (AS-BUILT)  
WORKS CONTRACT ENGINEER

Name :  
Prof. Reg. No. :  
Date :

SANRAL PROJECT MANAGER

Name :  
Date :

**V3 CONSULTING ENGINEERS**

39 SELATI STREET  
CORPORATE PLACE  
BUILDING B  
ASHLEA GARDENS  
PRETORIA, 0081

POSTNET SUITE 189  
PRIVATE BAG 104  
MENLO PARK, 0102  
TEL: (012) 045 0200  
FAX: (012) 455 0403

**M**

HERCHELLES COLLECTIVE

YOUR ENGINEERING NEEDS,  
OUR PASSION

BUILDING 1  
MAXWELL OFFICE PARK  
WATERFALL CITY  
MIDRAND, 1685

DESIGNED BY

NAME : D. DU TOIT  
Prof. Reg. No. : 201170110  
CHECKED BY

NAME : F. BOSHOFF  
Prof. Reg. No. : 870387  
DRAWN BY

NAME : M. KRUGER

CONSULTANT APPROVAL

Name : F. Boshoff  
Prof. Reg. No. : 870387  
Date : MARCH 2023

HEAD OFFICE  
48 Tambotie Avenue  
Val de Grace  
Pretoria  
0184

PO Box 415  
Pretoria 0001  
South Africa

Tel: (012) 844 8000

**SANRAL**  
SOUTH AFRICAN NATIONAL ROADS AGENCY SOC LTD

BUILDING SOUTH AFRICA  
THROUGH BETTER ROADS

NORTHERN REGION  
38 Ida Street  
Menlo Park  
Pretoria  
0081

Private Bag X17  
Lynnwood Ridge  
0040

Tel: (012) 426 6200

ACCEPTANCE

THIS ACCEPTANCE IS FOR PROCEDURAL AND ADMINISTRATIVE REVIEW PURPOSES ONLY AND DOES NOT ATTRACT LEGAL LIABILITY OR LIABILITY OF ANY KIND FROM WHATSOEVER CAUSE OR HOWEVER ARISING

for the SA NATIONAL ROADS AGENCY SOC LTD.  
Date:


PROJECT DESCRIPTION

THE IMPROVEMENT OF NATIONAL ROAD R33 SECTION 13 FROM MODIMOLLE KM 0.6 TO WITKLIP KM 13.6

DRAWING NAME  
KEY PLAN  
km 0.600 - km 7.600

SCALE : 1:1000

PROJECT NUMBER	NRA R.033-130-2019/1F	
DRAWING LOCATION DATA	KM 0.6	KM 13.6
ROUTE	R33	R33
SECTION	13	13
DRAWING km DISTANCE	0.6	13.6
DRAWING TYPE	ROADS - KEY PLAN	
BRIDGE/STRUCTURE No.	-	
CONSULTANT DRAWING No.	10314000-KP-01-00	
SANRAL DOCUMENT #	-	

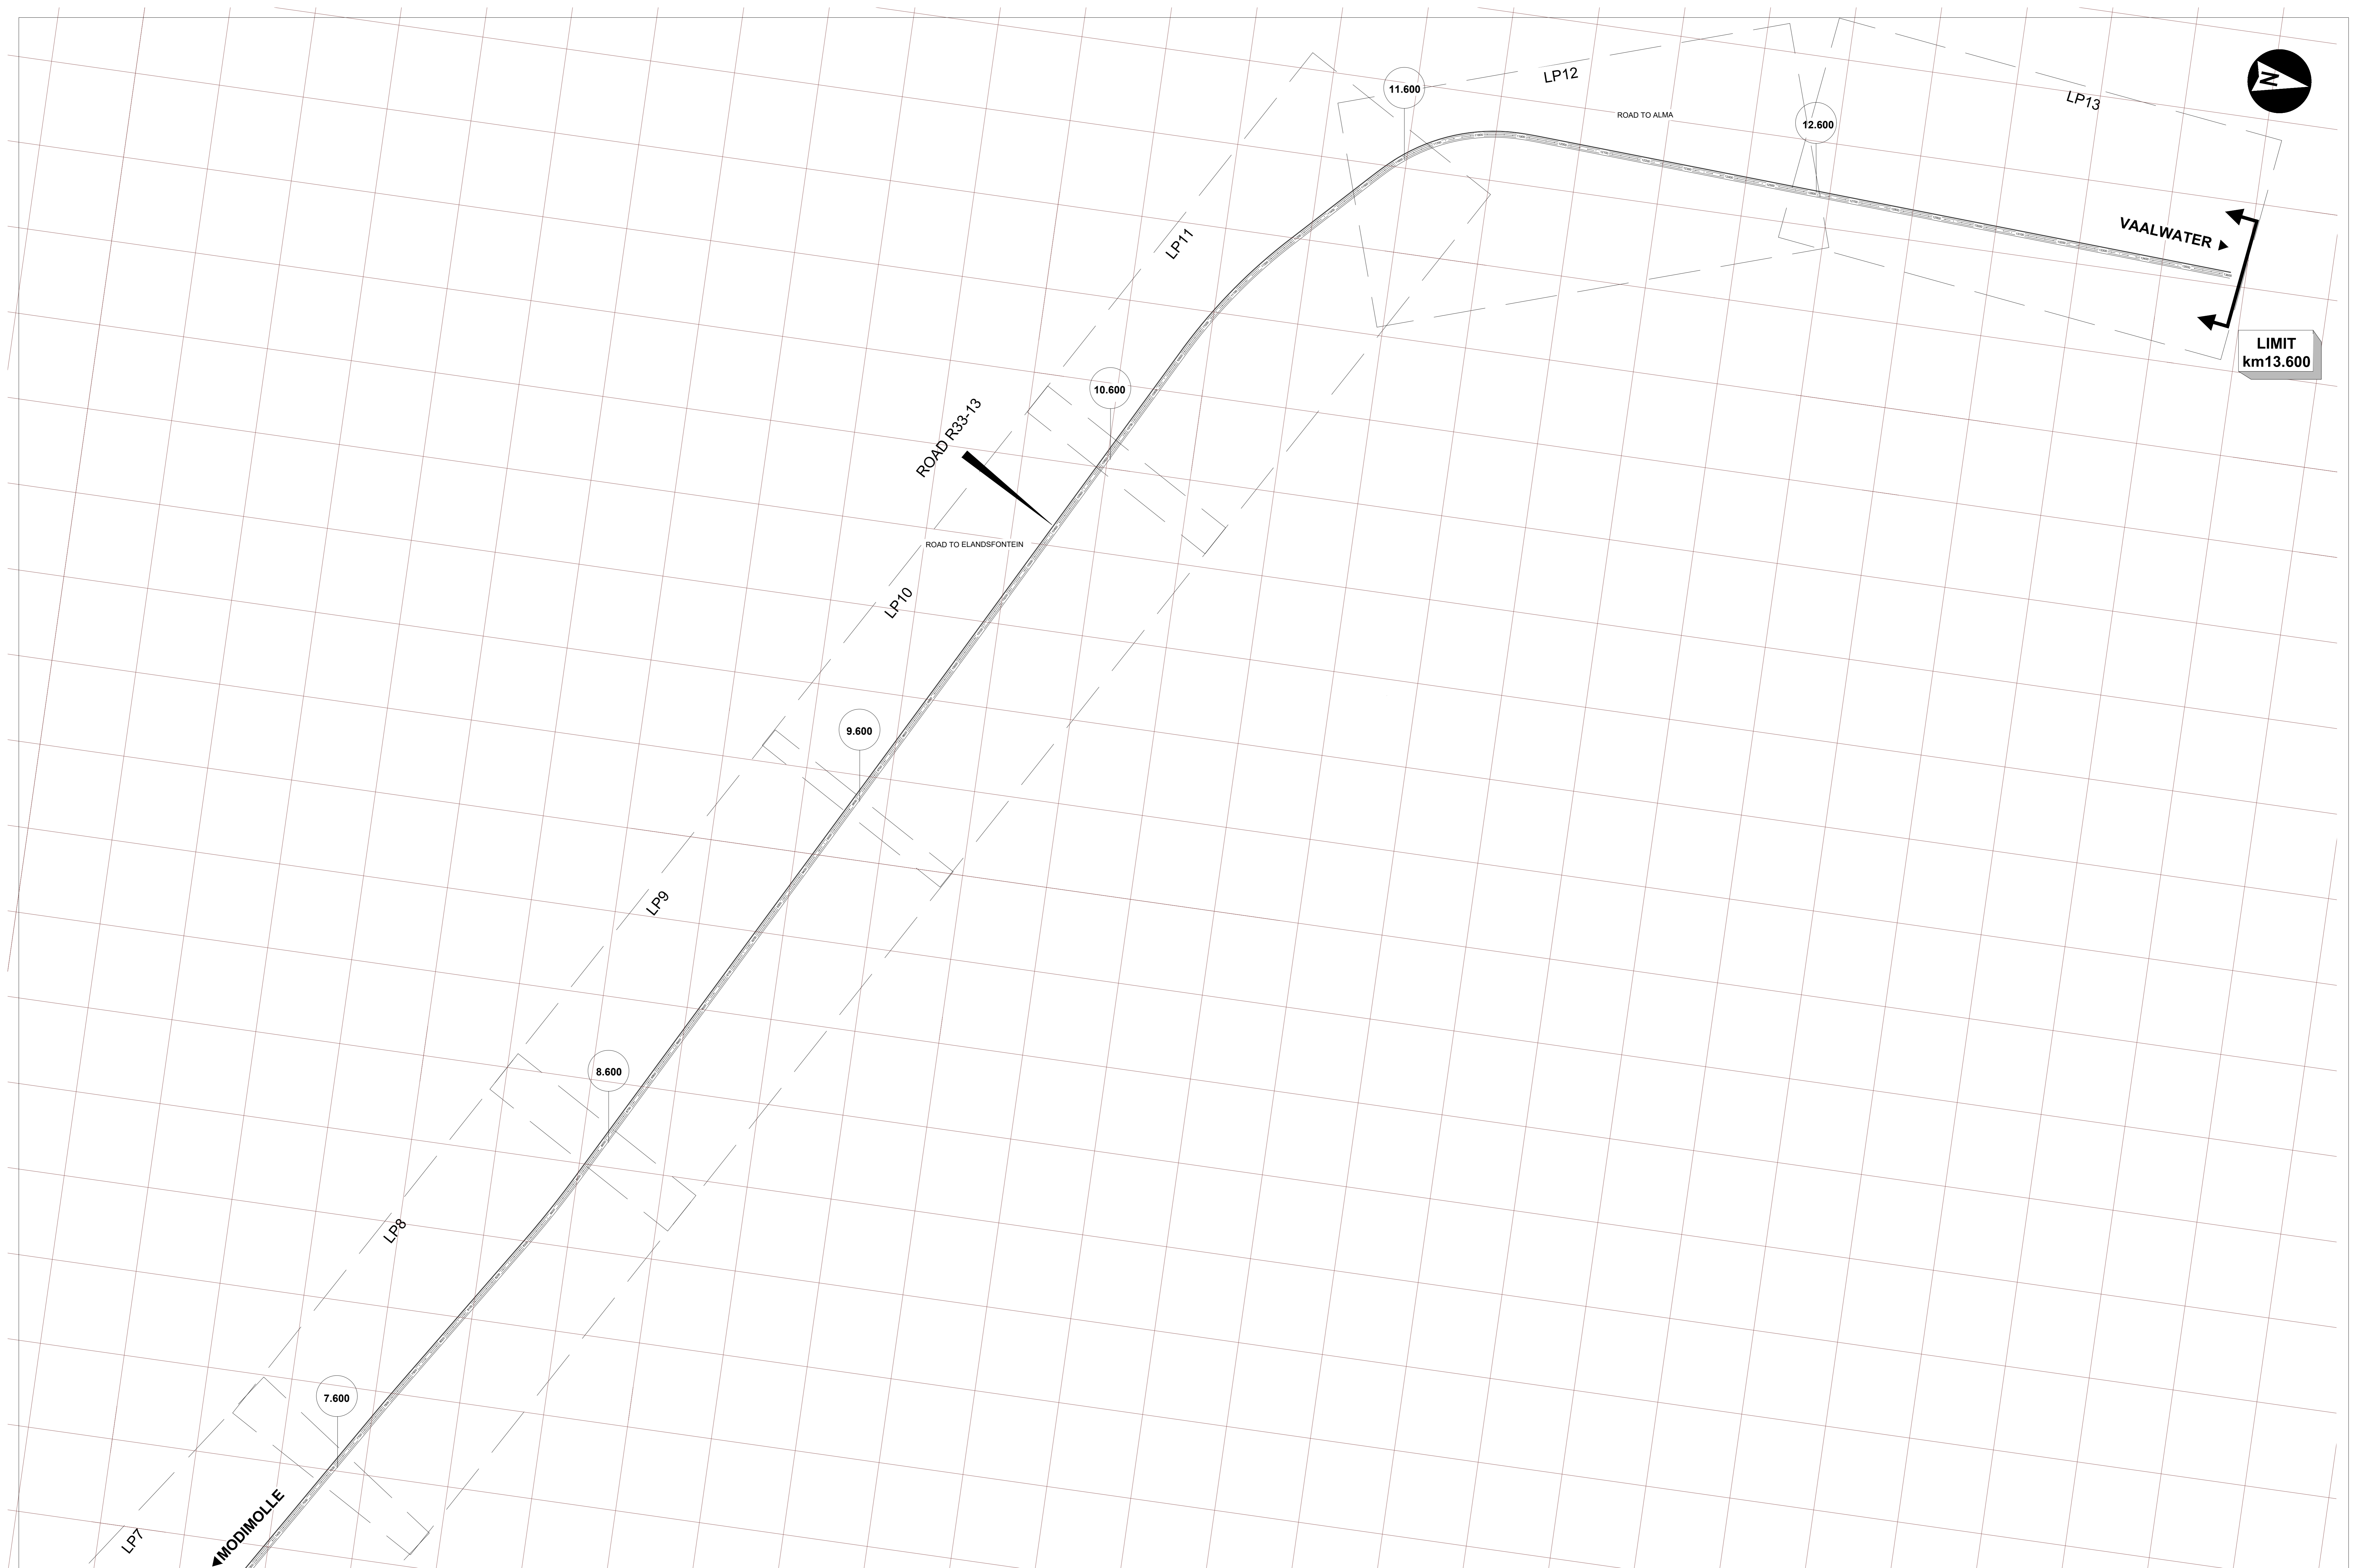

No.	DATE	REVISION
V1	MAR 2023	ORIGINAL VERSION

CONSTRUCTION RECORD (AS-BUILT)  
WORKS CONTRACT ENGINEER

Name :  
Prof. Reg. No. :  
Date :

SANRAL PROJECT MANAGER

Name :  
Date :

**V3 CONSULTING ENGINEERS**

39 SELATI STREET  
CORPORATE PLACE  
BUILDING B  
ASHLEA GARDENS  
PRETORIA, 0081

POSTNET SUITE 189  
PRIVATE BAG 004  
MENLO PARK, 0102  
TEL : (012) 045 0200  
FAX : (012) 455 0403

**M**  
HERCHELLES COLLECTIVE  
YOUR ENGINEERING NEEDS, OUR PASSION

BUILDING 1  
MAXWELL OFFICE PARK  
WATERFALL CITY  
MIDRAND, 1685

DESIGNED BY

NAME : R. NEL  
Prof. Reg. No. : 220150262  
CHECKED BY

NAME : R. NEL  
Prof. Reg. No. : 20150262  
DRAWN BY

NAME : R. NEL

CONSULTANT APPROVAL

Name : F. Boshoff  
Prof. Reg. No. : 470387  
Date : MARCH 2023

HEAD OFFICE  
48 Tambotie Avenue  
Val de Grace  
Pretoria  
0184

PO Box 415  
Pretoria 0001  
South Africa

Tel: (012) 844 8000

**SANRAL**  
SOUTH AFRICAN NATIONAL ROADS AGENCY SOC LTD

BUILDING SOUTH AFRICA  
THROUGH BETTER ROADS

NORTHERN REGION  
38 Ida Street  
Menlo Park  
Pretoria  
0081

Private Bag X17  
Lynnwood Ridge  
0040

Tel: (012) 426 6200

ACCEPTANCE

THIS ACCEPTANCE IS FOR PROCEDURAL AND ADMINISTRATIVE REVIEW PURPOSES ONLY AND DOES NOT ATTRACT LEGAL LIABILITY OR LIABILITY OF ANY KIND FROM WHATSOEVER CAUSE OR HOWEVER ARISING

for the SA NATIONAL ROADS AGENCY SOC LTD.  
Date:

PROJECT DESCRIPTION

THE IMPROVEMENT OF NATIONAL ROAD R33 SECTION 13 FROM MODIMOLLE KM 0.6 TO WITKLIP KM 13.6

DRAWING NAME  
KEY PLAN  
km 7.600 - km 13.600

SCALE : 1:1000

PROJECT NUMBER	NRA R.033-130-2019/1F	
DRAWING LOCATION DATA	KM 0.6	KM 13.6
ROUTE	R33	R33
SECTION	13	13
DRAWING km DISTANCE	0.6	13.6
DRAWING TYPE	ROADS - KEY PLAN	
BRIDGE/STRUCTURE No.	-	
CONSULTANT DRAWING No.	10314000-KP-02-00	VER
SANRAL DOCUMENT #	-	V1